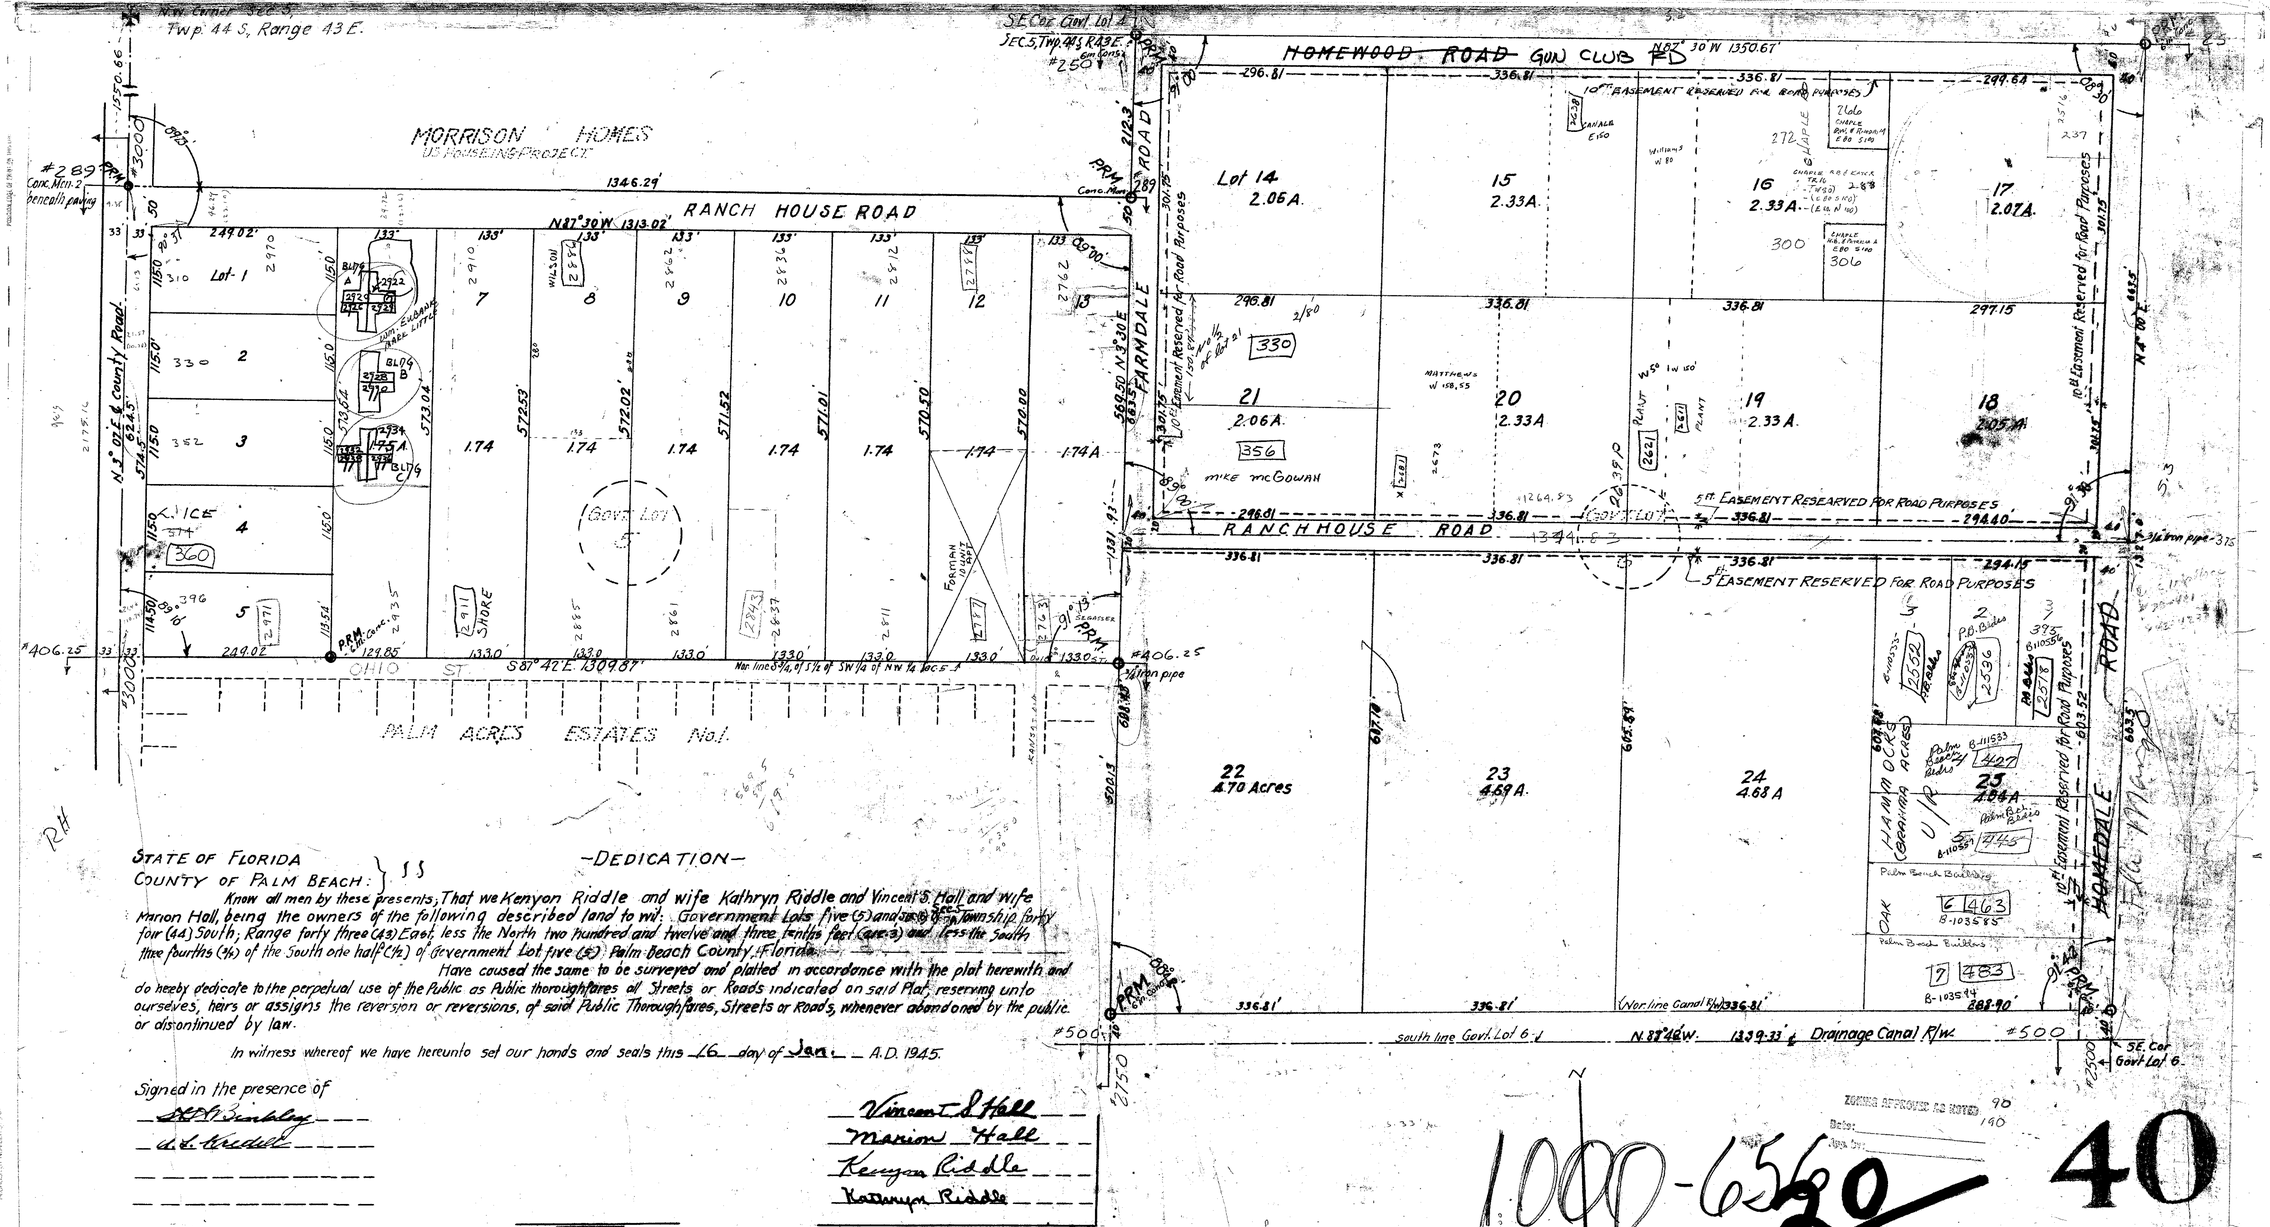

STATE OF FLORIDA
COUNTY OF PALM BEACH: } SS

-DEDICATION-

Know all men by these presents; That we Kenyon Riddle and wife Kathryn Riddle and Vincent S. Hall and wife Marion Hall, being the owners of the following described land to wit: Government Lots five (5) and six (6) in Township forty four (44) South; Range forty three (43) East, less the North two hundred and twelve and three tenths feet (212.3) thereof, less the South three fourths (¾) of the South one half (½) of Government Lot five (5) Palm Beach County, Florida.

Have caused the same to be surveyed and platted in accordance with the plat herewith and do hereby dedicate to the perpetual use of the Public as Public thoroughfares all Streets or Roads indicated on said Plat, reserving unto ourselves, heirs or assigns the reversion or reversions, of said Public Thoroughfares, Streets or Roads, whenever abandoned by the public or discontinued by law.

In witness whereof we have hereunto set our hands and seals this 16 day of Jan. A.D. 1945.

Signed in the presence of

Vincent S. Hall
Marion Hall
Kenyon Riddle
Kathryn Riddle

STATE OF FLORIDA
COUNTY OF PALM BEACH } SS

-ACKNOWLEDGMENT-

I hereby certify that on this day personally appeared before me an officer duly authorized to administer oaths and take acknowledgements, Kenyon Riddle and his wife Kathryn Riddle and Vincent S. Hall and his wife Marion Hall, to me well known and known by me to be the individuals described in and who executed the same freely and voluntarily for the purpose therein expressed, and I further certify that the said Kathryn Riddle and Marion Hall, on a separate and private examination taken and made by and before me, separated apart from their husbands, did acknowledge before me that they made themselves parties to the said Instrument for the purpose of renouncing, relinquishing, and conveying all their right title and interest whether of dower, homestead or of separate property, statutory or equitable in and to the Streets and Roads described and that they executed the same freely and voluntarily without constraint, compulsion, apprehension or fear from their said husbands.

Witness my hand and official seal this 16th day of January A.D. 1945, at West Palm Beach, Fla.

R. L. Calloway
Notary Public
My Commission expires on the 17th day of May A.D. 1945

STATE OF FLORIDA
COUNTY OF PALM BEACH } SS

-CERTIFICATE-

I hereby Certify that the tract of land shown hereon as Morrison Suburban Development is a correct representation of a survey made by me and is accurate to the best of my knowledge and belief and that permanent Reference Monuments have been placed as required by law.

J. B. Roberts
Land Surveyor, Florida Certificate No. 329

Subscribed and sworn to before me this 16 day of January A.D. 1945
R. L. Calloway
Notary Public

MORRISON SUBURBAN DEVELOPMENT

Approved January 24 A.D. 1945
By Board of County Commissioners
[illegible]
Palm Beach County Engineer

ZONING APPROVED AS NOTED 90 140
Date:
Appr. by:

1000-656 20/40

40

5/44/43

13

STATE OF FLORIDA
COUNTY OF PALM BEACH
24th January 2:00 P.M.
5
20 48
Deputy Clerk

MORRISON SUBURBAN DEVELOPMENT
A Subdivision in Govt Lots 5 & 6 in Section 5, Twp. 44 Sou. Range 43 East, Palm Beach County, FLORIDA
Surveyed by J. B. Roberts

20-40

DRAWING NUMBER 20-40